MTO

Project No.

Egpt. No.

: 120800-803

: 133-RB-1003

Client : Dangote Oil Refining Company

: EIL

Consultant

Ref. : 120800-803/MTO/SRN-03

Rev. : 1

Date : 13-04-2017

#### For Dimensions, refer sketch "120800-803-SRN03"

#### Notes:

- 1 Material: SA-336 Gr. F11 Cl.3
- 2 The material shall meet all the requirements of ASME Section II Part A Edition 2015.
- 3 Forgings shall meet all the requirements of API RP 934-C [Latest, Edition].
- 4 The forging shall be supplied in normalized & tempered condition or in quenched & tempered condition. Minimum tempering temperature shall be 15°C greater than simulation PWHT temperature.
- 5 The forgings shall be fine grained & vacuum degassed
- 6 The following additional chemical requirements shall also be meet by heat analysis.

X-bar = (10P + 5Sb + 4Sn + As) / 100 <= 15 ppm,

where P, Sb, Sn and As are in ppm.

Additionally, C = 0.15 wt % max, P = 0.007 wt % max, S = 0.007 wt % max, Cu = 0.20 wt % max and Ni = 0.30 wt % max.

- 7 Product analysis shall be carried out and reported in the material test certificates.
- 8 Simulation heat treatment of test coupons of the forgings shall be carried out according to the cycle given below.

Rate of Heating:

56°C/hr (maximum) above 300°C

Temperature:

Holding Time:

680 ± 10°. C

1.Min PWHT:

210 minutes

2.Max PWHT:

630 minutes

Rate of Cooling:

56°C/hr (maximum) upto 300°C

- 9 All the mechanical tests shall be reported for the following.
  - 1) As Supplied
  - 2) As Supplied + Minimum PWHT Condition
  - 3) As Supplied + Maximum PWHT Condition
- 10 All forgings shall be impact tested at -18°C as per ASME Sec VIII Div 1 [Edition 2015]. The minimum impact energy shall be 54 J average of three specimens and 27 J minimum for a single specimen.

Number of test shall be carried out considering 1 set of 3 specimens per test condition.

Test specimens shall be taken from normal to the direction of greatest elongation at 1/2 T location.

Percentage shear fracture shall meet 25% minimum. Lateral expansion shall also be reported.

- 11 All forgings shall be ultrasonically examined with 100% scanning in accordance with paragraph 3.3.4 of ASME Sec VIII Div 2 [Edition 2015].
- 12 Entire surfaces of forgings including welding edges shall be magnetic particle examined in accordance with para 7.5.6 of ASME Sec VIII Div 2 [Edition 2015] after finish machining.
- 13 Room temperture Tensile test shall be performed. 2 test per forging (taken at 180°apart) of each size in each heat and heat treatment charge shall be performed. Test specimen shall be taken at 1/2T location in tangential direction. Acceptance criteria shall be as per SA-336 of ASME Sec II Part A [2015 Edition].
- 14 The hardness shall not exceed 200 BHN. Hardness test shall be perform on each tensile test specimen prior to tensile testing using Brinell, Vickers or Rockwell Methods.
- 15 Repair by welding is not permitted.
- 16 Forging shall be supplied in fully machined condition. Vendor shall submit forging sketches for Godrej approval. Manufacturing activities should start only after approval of sketches by Godrej.
- 17 Forgings shall be legibly stamped or stenciled showing grade no. and item no. with "low stress stamp". Certification and Marking shall be in accordance with SA-336 of ASME Section II Part A [Edition 2015].
- 18 Inspection: Material test reports shall be in accordance with EN 10204 Type 3.2 (Lloyds/TUV Nord/BV).

Rev 1: Sketch revised as marked

ASME

**MASTER COPY** 


Approved By: PDY

G. CO. LTD. RESERVES ALL RIGHTS WHATSOEVER BEEN CONCEIVED BY THE DINT OF ITS EFFORTS AS A VIOLATION OF ITS COPYRIGHT. NO PART OF MFG. CO. LTD. . GODREJ & BOYCE MFG. CO. LT IE DRAWINGS THAT HAVE BEEN C. IC OR OTHER CHANGES, AS A VIC AL OF GODREJ & BCYCE MFG. C. THE DRAWINGS ARE THE COPYRIGHTED WORKS OF GODREJ & BOYCE MFG. CO. LTD. G IN THE DRAWINGS. GODREJ & BOYCE MFG. CO. LTD. ASSERTS ITS RIGHTS OVER THE AND ALSO VIEWS REPRODUCTION OF THE DRAWINGS, AS IS OR BY MAKING COSMETIC THE DRAWINGS SHALL BE COPIED OR REPRODUCED WITHOUT THE WRITTEN APPROVAL

REV.	DATE	DESCRIPTION	ALTE	GLUVD		T			·		
		BBOOKH HON	ALTD	CHKD.	APPD.	REV.	DATE	DESCRIPTION	ALTD	CHKD.	APPD.
			ľ							<u> </u>	
	MOMBO		ــــــ	L	L		***************************************				1


### NOTES:-

- 1) ALL DIMENSIONS ARE IN MILLIMETERS, UNLESS OTHERWISE SPECIFIED.
- 2) FOR GENERAL NOTES, REFER DOC. 120800-803/MTO/SRN-03

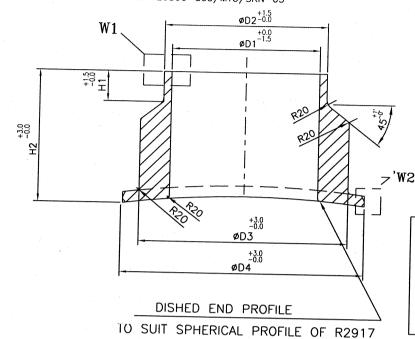


DETAIL 'W1'
AS FOLLOWS

FLANGES	FIG	ASME
<24"	8/9	B 16.5
>24"	1	B 16.47

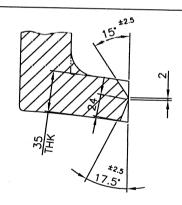

<u>DETAIL 'W2'</u> FOR SERIAL NO.1

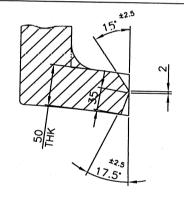

DETAIL 'W2'
FOR SERIAL NO. 2 & 3

3	N2	712	762	912	1012	50	335	SRN03	1
2	M1	926	994	1146	1246	74	380	SRN02	<del>  -</del>
1	N3 A-D	193.68	219.08	324	424	50	230	SRN01	4
SR. No.	NOZZLE MARK	D1	DS	D3	D4	H1	H2	ITEM CODE	QTY.

SCALE: TITLE: DETAILS OF SRN

NTS EQUIPMENT NO: 133-RB-1003

MATERIAL
SA 336 GR F11 CL3

QUANTITY REFER TABLE

CLIENT: DANGOTE OIL REFINING COMPANY

Godrej

Godrej & Boyce Mfg. Co. Ltd.

Process Equipment Division

DRAWN DATE ( MK 08/03/17

CNECKND 08

 PROJECT NO.: 120803


 DATE
 APPROVED
 DATE

 08/03/17
 MP
 08/03/17


DRG. NO.:120800-803-SRN03

SHT. 1 OF 7

REV.0

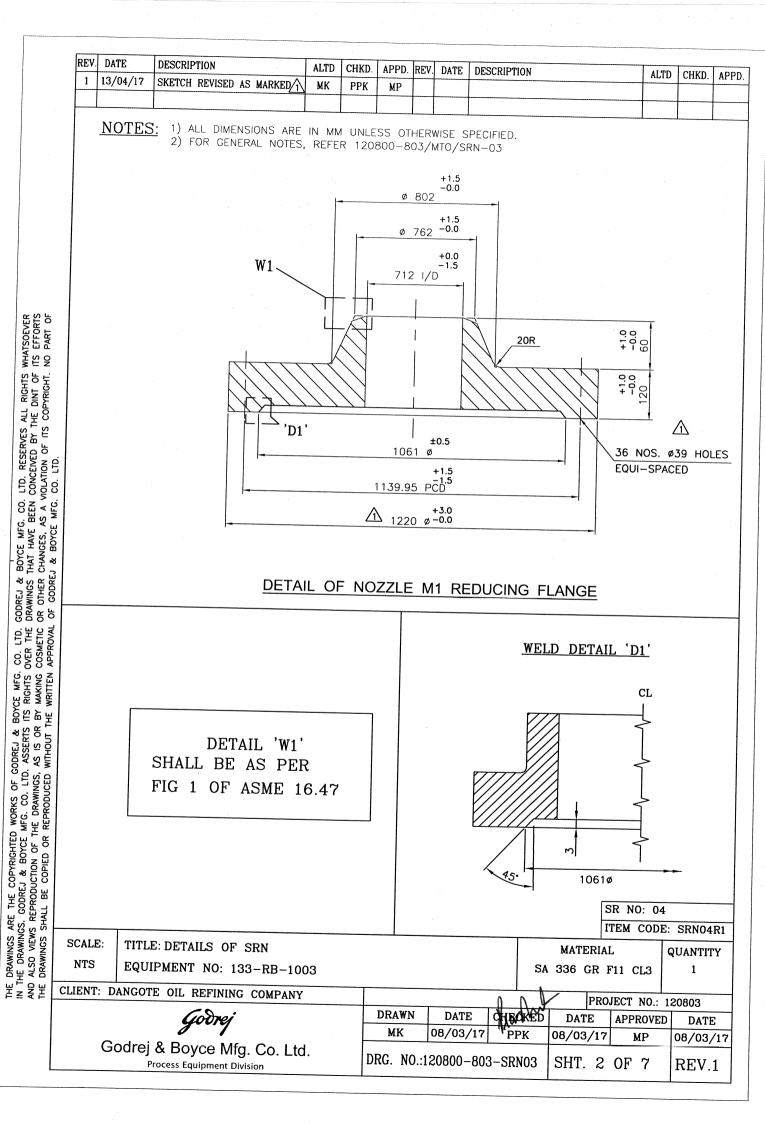

REV.	DATE	DESCRIPTION	ALTD	CHKD.	APPD.	REV.	DATE	DESCRIPTION		ALTD	CHKD.	AF
1	13/04/17	SKETCH REVISED AS MARKED	↑ MK	PPK	MP							
	Nompo			<u> </u>								L
	NOTES: 1) ALL DIN	T MENSIONS ARE IN MILLIMETERS	S LINIFS	SOTHER	DWICE O	DEC	EIED					
	2) FOR GE	ENERAL NOTES, REFER DOC.	120800-8	B03/MT	O/SRN-	-03	illo.					
							+3.0					
					$\triangle$	1220	-0.0					
							+1.5					
					11.	39.95	-1.5 PCD					
						100	±0.5					
			<del></del>			106	l Ø			-		
											D1'	
						<u> </u>					00	
											114	- 0
		V4////								<i>TX</i>		- 1
		<b>₩</b>				1				/		
						<u> </u>			1//			
						<u>†</u> 926	0.0 1.0					
		W1 -				920				75 1106	$\triangle$	
						+ - 998	1.5 0.0				ø39 -SPACE	
		<del>  -</del>				330					00.	
						_	1.5 -0.0		-			
		<b>-</b>			1	016						
			DET	- A II - 7	)E N	07	71 E.C. N	44				
			DLI	AIL (		UZ.	ZLES N	<u>″11</u>				
					ŀ							
								45				
								< +	1061ø			
									2			
				1								
		DD0111 1 1					E		<b>7</b> 1	\ \frac{1}{2}		
	CHEA	DETAIL 'W1'					Ł		1			
		ALL BE AS PER	. ~.					\//		<b>\</b>		
	НG	1 OF ASME 16.4	17									
- [									4	$\rightarrow$		
								WELD D	ETAIL 'D1'	CL		
										NO O	·	
										R NO : O		IO F
SCA	LE: TIT	LE: DETAILS OF SRN		***************************************			<del></del>	1	MATERIAL		QUANT	
NT		UIPMENT NO: 133-RB-	-1003		•			SA	MATERIAL 336 GR F1	. 1	QUAN I	. 1 1
				<del></del>								
TIEV	II: DANG	OTE OIL REFINING COMPA	ANY		DRAV	A/NI	DAME	dane cked		CT NO.:		
		Goorej			DRA		DATE 08/03/1		DATE // 08/03/17	APPROVED MP	DA 08/0	
	Godr	ej & Boyce Mfg. Co.	1 44	ŀ				A CONTRACTOR OF STREET	20,00,11	141.1	100/0	
	Obuit	of a polyce filly. Co.	Liu.	ŧ	מתת	110 4	00000	303-SRN03	SHT. 3 (	OF 7	REV	

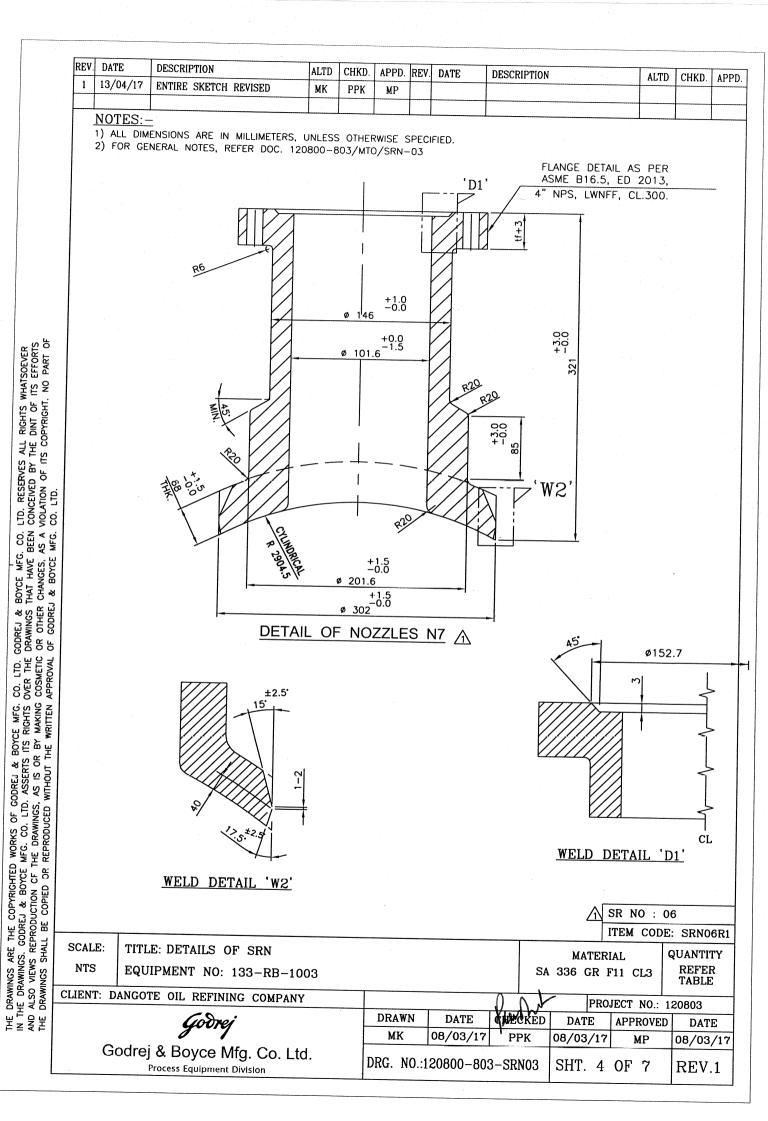

REV.	DATE	DESCRIPTION	ALTD	CHKD.	APPD.	REV.	DATE	DESCRIPTION	ALTD	CHKD.	APPD.
1	13/04/17	SKETCH DELETED	MK	PPK	MP						
											· · · · · · · · · · · · · · · · · · ·

NOTES:-

- 1) ALL DIMENSIONS ARE IN MILLIMETERS, UNLESS OTHERWISE SPECIFIED.
- 2) FOR GENERAL NOTES, REFER DOC. 120800-803/MTO/SRN-03

DELETED

SR NO: 07

ITEM CODE: SRN07R1

SCALE: TITLE: DETAILS OF SRN NTS

EQUIPMENT NO: 133-RB-1003

MATERIAL SA336 GR F11 CL3 QUANTITY REFER TABLE

CLIENT: DANGOTE OIL REFINING COMPANY

Godrej & Boyce Mfg. Co. Ltd.

Process Equipment Division

du pocké d ΜK 08/03/17 ₽PK DRG. NO.:120800-803-SRN03

DATE

DRAWN

DATE APPROVED DATE 08/03/17 08/03/17

SHT. 5 OF 7 REV.1


PROJECT NO.: 120803

THE DRAWINGS ARE THE COPYRIGHTED WORKS OF GODREJ & BOYCE MFG. CO. LTD. GODREJ & BOYCE MFG. CO. LTD. RESERVES ALL RIGHTS WHATSOEVER IN THE DRAWINGS. GODREJ & BOYCE MFG. CO. LTD. ASSERTS ITS RIGHTS OVER THE DRAWINGS THAT HAVE BEEN CONCEIVED BY THE DINT OF ITS EFFORTS AND ALSO VIEWS REPRODUCTION OF THE DRAWINGS, AS IS OR BY MAKING COSMETIC OR OTHER CHANGES, AS A VIOLATION OF ITS COPYRIGHT. NO PART OF THE DRAWINGS SHALL BE COPIED OR REPRODUCED WITHOUT THE WRITTEN APPROVAL OF GODREJ & BOYCE MFG. CO. LTD.

REV.	DATE	DESCRIPTION	ALTD	CHKD.	APPD.	REV.	DATE	DESCRIPTION	ALTD	CHKD.	APPD.
									1.5		
<u> </u>											
1	MOTEC.							·			

# NOTES:-

- 1) ALL DIMENSIONS ARE IN MILLIMETERS, UNLESS OTHERWISE SPECIFIED.
- 2) FOR GENERAL NOTES, REFER DOC. 120800-803/MTO/SRN-03

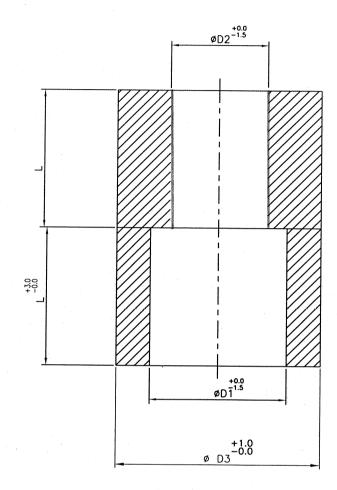

08	N1-VERTICAL SPOOL 1	712	706	762	175	SRN08	1
SR. NO.	NOZZLE MARK	D1	D2	D3	L	ITEM CODE	QTY.

SCALE:	TITLE: DETAILS OF SRN				MATI	ERIAL		QUANTITY
NTS	EQUIPMENT NO: 133-RB-1003			^	SA33	36 GR F11	CL3	REFER TABLE
CLIENT: I	DANGOTE OIL REFINING COMPANY			1	M	/ PRO	JECT NO.: 1	20803
	Godrej	DRAWN	DATE	d	FERED	DATE	APPROVED	DATE
	J 19	MK	08/03/17		\ <sub>PPK</sub>	08/03/17	MP	08/03/17

DRG. NO.:120800-803-SRN03

SHT. 6 OF 7

REV.0

Godrej & Boyce Mfg. Co. Ltd.


Process Equipment Division

THE DRAWINGS ARE THE COPYRIGHTED WORKS OF GODREJ & BCYCE MFG. CO. LTD. GODREJ & BOYCE MFG. CO. LTD. RESERVES ALL RIGHTS WHATSOEVER IN THE DRAWINGS. GODREJ & BOYCE MFG. CO. LTD. ASSERTS ITS RIGHTS OVER THE DRAWINGS THAT HAVE BEEN CONCEIVED BY THE DINT OF ITS EFFORTS AND ALSO VIEWS REPRODUCTION OF THE DRAWINGS, AS IS OR EY MAKING COSMETIC OR OTHER CHANGES, AS A VIOLATION OF ITS COPYRIGHT. NO PART OF THE DRAWINGS SHALL BE COPPIED OR REPRODUCED WITHOUT THE WRITTEN APPROVAL OF GODREJ & BOYCE MFG. CO. LTD.

REV	DATE	DESCRIPTION	ALTD	CHKD.	APPD.	REV.	DATE	DESCRIPTION	ALTD	CHKD.	APPD.
	1										

## NOTES:-

- 1) ALL DIMENSIONS ARE IN MILLIMETERS, UNLESS OTHERWISE SPECIFIED.
  2) FOR GENERAL NOTES, REFER DOC. 120800-803/MTO/SRN-03

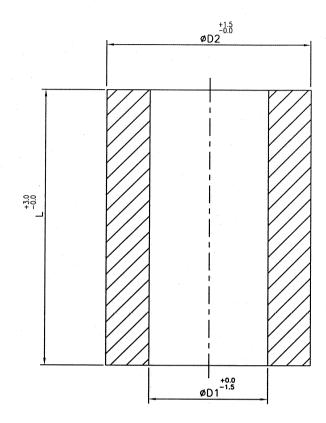

14	N6, N7 NECK	66.64	88.9	275	SRN14	2
13	N3A-D - SPOOL 2	193.68	219.08	745	SRN13	4
12	N3A-D - SPOOL 1	193.68	219.08	830	SRN12	4
11	N2-HORIZONTAL SPOOL	712	762	785	SRN11	3
10	N2-VERTICAL SPOOL	712	762	275	SRN10	1
09	N1-HORIZONTAL SPOOL	706	762	410	SRN09	1
SR. NO.	NOZZLE MARK	D1	DS	L	ITEM CODE	QTY.

SCALE:	TITLE: DETAILS OF SRN					ERIAL		1	QUANTITY
NTS	EQUIPMENT NO: 133-RB-1003				SA33	6 GR	F11	CL3	REFER TABLE
CLIENT: D	ANGOTE OIL REFINING COMPANY			0 0		/	PRO	JECT NO.:	120803
	Godrej	DRAWN	DATE	OF THE	cked	DAT	Έ	APPROVED	DATE
	georg	MK	08/03/17	r <sub>Pi</sub>	κ	08/03	/17	MP	08/03/17
G	odrej & Boyce Mfg. Co. Ltd.  Process Equipment Division	DRG. NO.:	120800-803	3-SR	N03	SHT.	7	OF 7	REV.0

THE DRAWINGS ARE THE COPYRIGHTED WORKS OF GODREJ & BOYCE MFG. CO. LTD. GODREJ & BOYCE MFG. CO. LTD. RESERVES ALL RIGHTS WHATSOEVER IN THE DRAWINGS. GODREJ & BOYCE MFG. CO. LTD. ASSERTS ITS RIGHTS OVER THE DRAWINGS THAT HAVE BEEN CONCEIVED BY THE DINT OF ITS EFFORTS AND ALSO VIEWS REPRODUCTION OF THE DRAWINGS, AS IS OR BY MAKING COSMETIC OR OTHER CHANGES, AS A VIOLATION OF ITS COPYRIGHT. NO PART OF THE DRAWINGS SHALL BE COPIED OR REPRODUCED WITHOUT THE WRITTEN APPROVAL OF GODREJ & BOYCE MFG. CO. LTD.